



**NOTICE OF PUBLIC HEARING
MINOR VARIANCE**

Pursuant to Section 45(5) of *The Planning Act*

FILE NUMBER: MV-2021-14

APPLICANT: Bakhshi

PROPERTY: 25 Bailey Crescent
PLAN 514 S PT LOT 177

RELATED APPLICATIONS: n/a

ZONING: R6 (Semi-Detached and Duplex Dwelling Residential Zone)

PURPOSE: A Minor Variance Application has been submitted to facilitate an existing storage shed.

BY-LAW REQUIREMENT:

- 1) Section 4.1.1 of the Zoning By-law requires a minimum rear yard setback of 1m for accessory structures; and
- 2) Section 7.2 of the Zoning By-law requires a minimum side yard setback of 1.2m

PROPOSAL:

- a) The applicant is proposing a storage shed which is 0.58m from the rear lot line; and
- b) The applicant is proposing a storage shed which is 0.46m from the side lot line.

A Location Map and Site Plan illustrating the request are attached. This Application will be heard by the Committee of Adjustment on the Date and Time shown below.

DATE:	July 8, 2021
TIME:	7:00 p.m.
LOCATION:	Electronic Meeting (Please visit https://www.youtube.com/user/Townofaurora2012 for live stream of the meeting)

NOTE: As a result of COVID-19, Town Hall and other Town facilities have been CLOSED to the public. During this time, Committee of Adjustment meetings will be held electronically and may be viewed via live stream. Please visit the Town’s website for further details.

You may express your views about this Application, for consideration by the Committee, in the following ways:

- i) **Participate in the electronic meeting as a live delegate.** Please send a delegation request to the Secretary–Treasurer, Brashanthe Manoharan, at BManoharan@aurora.ca **no later than 4:30pm on July 6, 2021**. Once the request has been received, instructions will be provided on how to make your delegation during the electronic meeting.

The Delegation Request form is located on the Town website: <https://www.aurora.ca/en/business-and-development/resources/development-planning/Committee-of-Adjustment/Delegation-Request-Form--Fillable.pdf>

- ii) **Provide written comments.** Please email your comments to the Secretary – Treasurer, Brashanthe Manoharan, at BManoharan@aurora.ca **no later than 12:00pm (noon) on July 8, 2021**. Alternatively, comments may be mailed to Town Hall at the address below. Please note, mailed comments must be received by the Town prior to the meeting in order to be considered by the Committee.

*Town of Aurora
100 John West Way, Box 1000
Aurora, ON L4G 6J1*

If you wish to be notified of the Decision with respect to this Application, you must complete the enclosed “Request for Decision” form. The form can also be found at <https://www.aurora.ca/en/business-and-development/resources/development-planning/Committee-of-Adjustment/Request-for-Decision--Fillable.pdf>. This form is to be emailed to BManoharan@aurora.ca **no later than 4:30pm on July 9, 2021**.

If you receive this notice as an owner of land containing seven or more residential units, please post this notice in a location that is visible to all property residents.

Should you have any questions regarding this application, please contact Brashanthe Manoharan at BManoharan@aurora.ca or at **905-727-3123 Ext. 4223**.

Personal Information Collection Notice

Your personal information and your comments are collected under the legal authority of the *Planning Act, R.S.O. 1990, Chapter c.P.13*, as amended. Your comments in respect to this Application will become part of the decision making process of the Application as noted on this form. Pursuant to Section 27 of the *Municipal Freedom of Information and Protection of Privacy Act, R.S.O. 1990, c. M.56*, as amended, (the “Act”) public feedback to planning proposals is considered to be a public record and may be disclosed to any individual upon

request in accordance with *the Act*. Questions about this collection should be directed to the Town Clerk, Town of Aurora, 100 John West Way, Box 1000, Aurora ON L4G 6J1 905-727-3123.

DATED THIS 24th DAY OF JUNE 2021



Brashanthe Manoharan
Secretary-Treasurer
Committee of Adjustment

ATTACHMENTS

Attachment 1 – Location Map
Attachment 2 – Site Plan
Attachment 3 – Request for Decision

Agenda packages will be available prior to the Hearing at:

<https://www.aurora.ca/agendas>




LOCATION MAP

25 BAILEY CRESCENT
FILE: MV-2021-14




SUBJECT LANDS

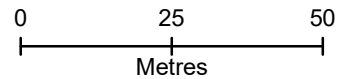

**SURVEYOR'S REAL PROPERTY REPORT
SHEET 1
PLAN OF
PART OF LOT 177
REGISTERED PLAN 514
TOWN OF AURORA
REGIONAL MUNICIPALITY OF YORK**

LLOYD & PURCELL LTD., 1997, SCALE 1:200

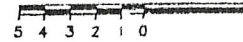

NOTE:

DISTANCES SHOWN ON THIS PLAN ARE IN METRES AND CAN BE CONVERTED DIVIDING BY 0.3048.

BEARING REFERENCE:

BEARINGS ARE ASTRONOMIC AND ARE REFERRED TO THE EASTERLY LIMIT OF SHOWN ON REGISTERED PLAN 514 HAVING A BEARING OF N16°43'00"W.

© COPYRIGHT 1997 LLOYD & PURCELL LTD.

THE REPRODUCTION, ALTERATION, OR USE OF THIS REPORT, IN WHOLE OR IN EXPRESS PERMISSION OF LLOYD & PURCELL LTD. IS STRICTLY PROHIBITED.

LEGEND:

- S.I.B. STANDARD IRON BAR
- I.B. IRON BAR
- FOUND
- SET
- meas. MEASURED
- 1110 R. D. TOMLINSON O.L.S. SURVEY RECORDS OF UNWIN, MURPHY & ESTEN DATED, JULY 13, 1960.
- UME REGISTERED PLAN 514
- pl1 OVERHEAD BELL
- B- OVERHEAD HYDRO
- H- OVERHEAD WIRE
- OHW FENCE CORNER
- f.c. CORNER
- Cor. CORNER

SURVEYOR'S CERTIFICATE:

I CERTIFY THAT:

1. THIS SURVEY AND PLAN ARE IN ACCORDANCE WITH THE SURVEYS ACT AND THE REGULATIONS MADE THEREUNDER.
2. THE SURVEY WAS COMPLETED ON OCTOBER, 1997.

30/10/97

Neil
NEIL
CORNER
ONTARIO L


SHEET 2

COMMENTS; --ALL BUILDING TIES HEREON ARE TO CONCRETE FOUNDATION UNLESS OTHERWISE INDICATED.
--NOTE FRAME SHED IS OVER SOUTHERLY LIMIT BY TIES AS SHOWN ON SHEET 1.
--OVERHEAD BELL CROSSES SOUTH-EAST CORNER OF PROPERTY.
--BOARD FENCE SOUTH OF SOUTHERLY LIMIT BY TIES AS SHOWN ON SHEET 1.

EASEMENTS; SUBJECT TO AN EASEMENT AS IN INSTRUMENT N° A21726A.

THIS REPORT WAS PREPARED FOR MAURICE BLANCHARD AND THE UNDERSIGNED ACCEPTS NO RESPONSIBILITY FOR USE BY OTHER PARTIES.


LLOYD & PURCELL LTD. ONTARIO LAND SURVEY
1228 GORHAM ST., UNIT 28, NEWMARKET, ONTARIO, L3Y-7V1, (905)895-8416, FILE N

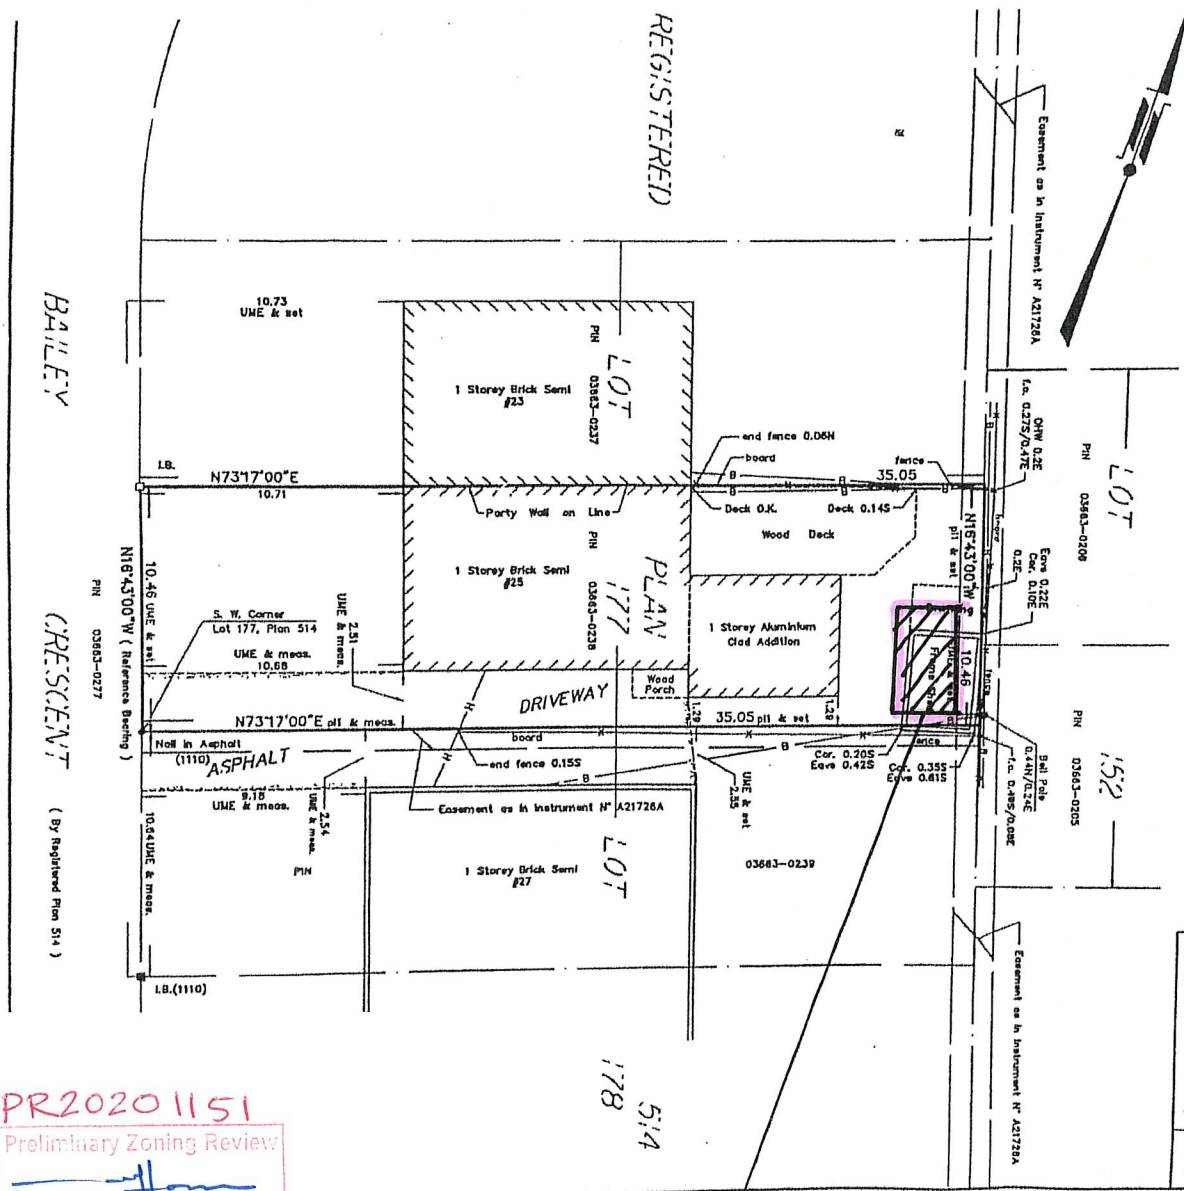

PR20201151
Preliminary Zoning Review
FEB 04 2021
PLANNING AND DEVELOPMENT SERVICES
Building Division

NEW SHED

25 BAILEY CRES.
AURORA, ON

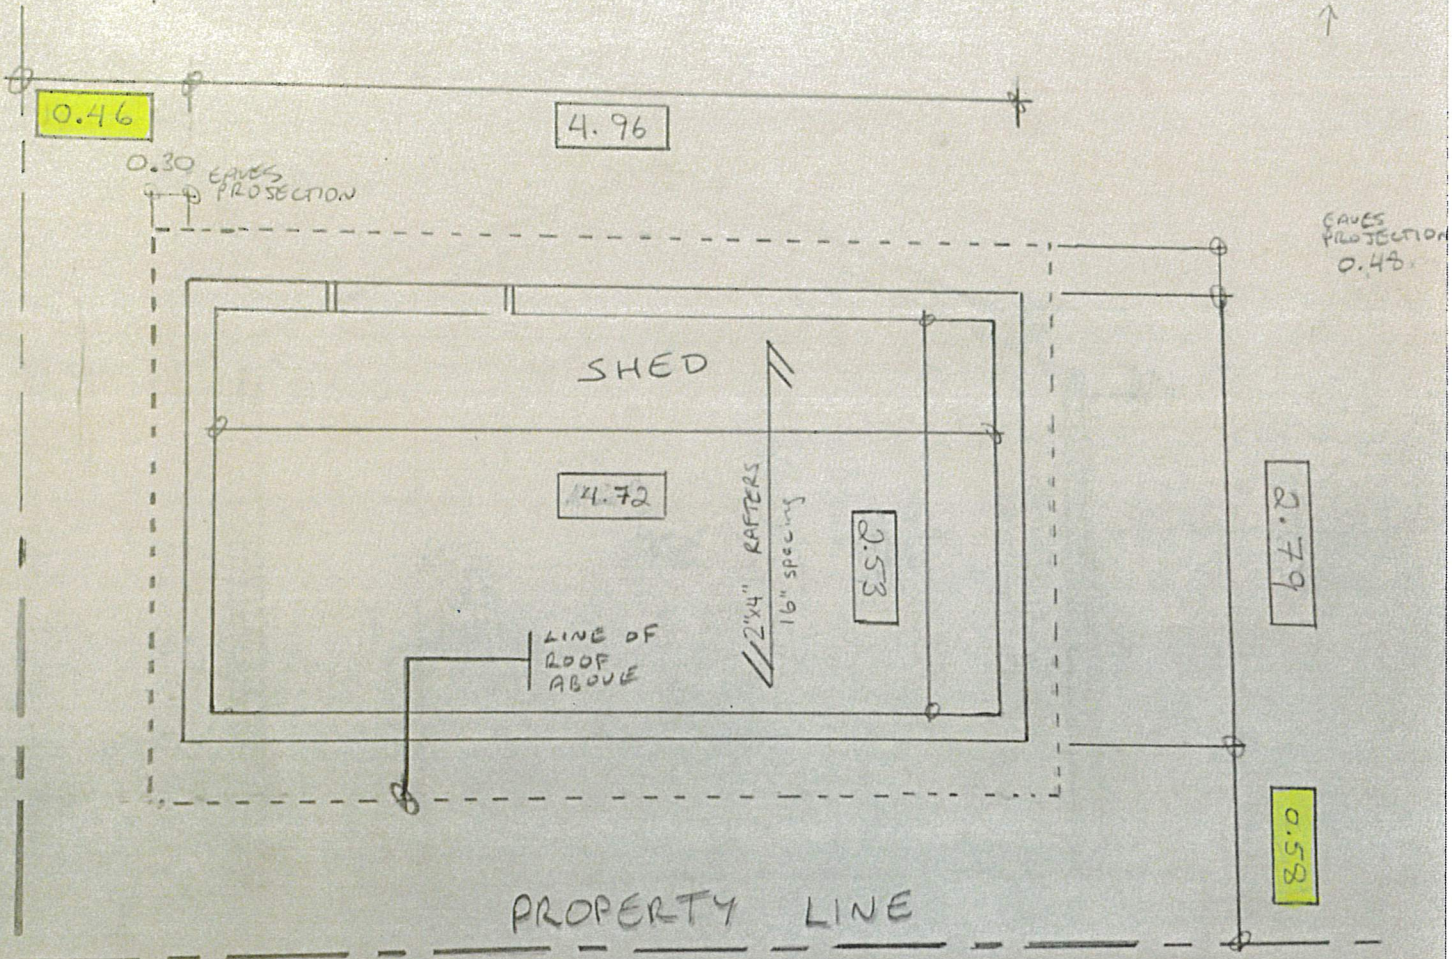

SHED PLAN
(AS BUILT)


Preliminary Zoning Review
FEB 04 2021
PLANNING AND DEVELOPMENT SERVICES
Building Division

PR20201151

Top

PR20201151
Preliminary Zoning Review
FEB 04 2021
PLANNING AND DEVELOPMENT SERVICES
Building Division

Rear

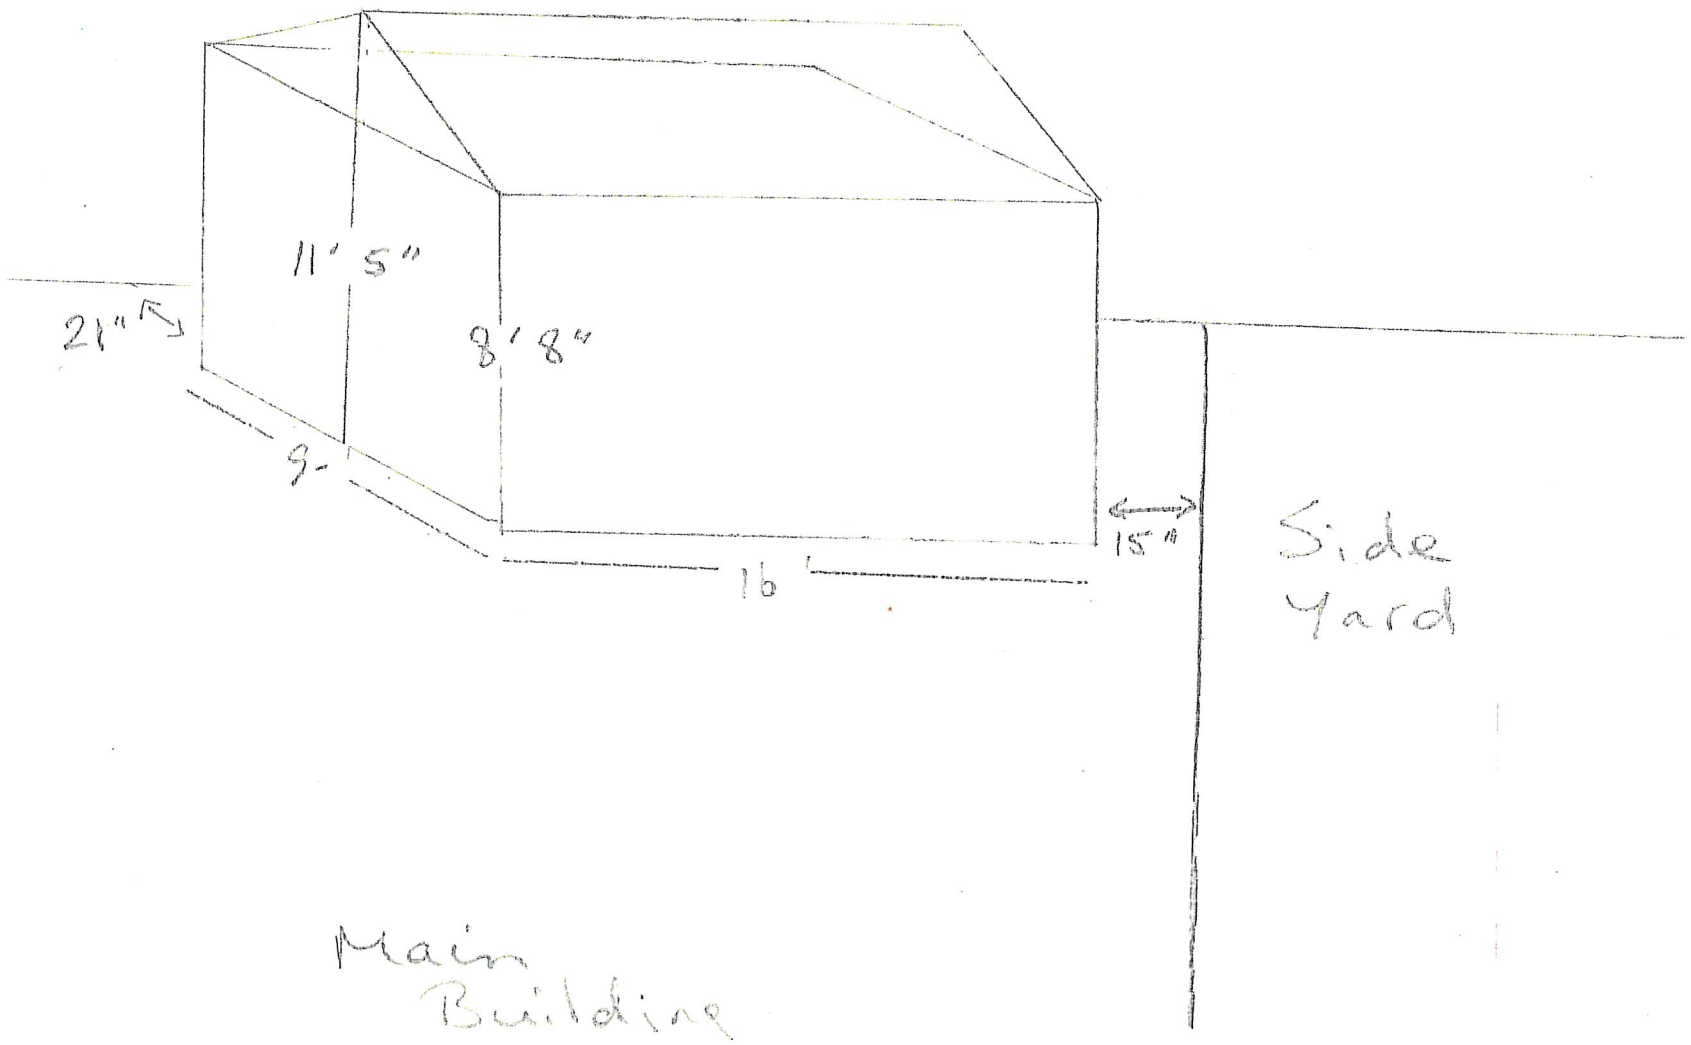

Main Building

Side Yard



TOWN OF AURORA COMMITTEE OF ADJUSTMENT REQUEST FOR DECISION

Meeting Date: _____ Agenda Item Number: _____

Application Name: _____

File Number(s): _____

IMPORTANT NOTICE

You must complete this form and submit it to the Secretary-Treasurer to ensure your name and address are accurately noted for future notification.

This meeting is your opportunity to voice any opinions or comments you may have regarding an Application for approval of a Minor Variance/Permission or Consent. Under the *Planning Act*, for a Minor Variance and Permission, Section 45(10) states that the Secretary-Treasurer shall send one copy of the decision, to each person or public body who appeared in person or by counsel at the hearing AND who filed with the Secretary-Treasurer a written request for Notice of the Decision. For Consent, Section 53(17) states that if the Committee gives or refuses to give provisional Consent, the Committee shall ensure written Notice of the Decision is given to each person or public body that made a written request to be notified of decision or conditions.

NOTE: Due to COVID-19, all Request for Decisions shall be emailed to Brashanthe Manoharan, Secretary-Treasurer, at bmanoharan@aurora.ca.

Please print clearly and provide information requested below.

Name: _____
(MR./MRS./MS) (First) (Last)

Address: _____

Municipality: _____ Postal Code: _____
(Must Be Provided)

Telephone: Residence _____ E-Mail: _____
Business _____ E-Mail: _____

Notice of Decision and/or future consideration of this Committee of Adjustment Application will be provided by E-Mail.

NOTE: Notice of this meeting was given by mail to all owners within 120 metres (400 feet) of the subject lands

Personal information on this form is collected under the legal authority of the *municipal act*, R.S.O.1990, and C.M.45, as amended. This information will be used for the purposes of sending correspondence relating to matters before council. The information is collected and maintained for the purpose of creating a record that is available to the general public pursuant to section 27 of the *municipal freedom of information and protection of privacy act*, R.S.O. 1990, C.M.56, as amended. Questions about this collection should be directed to the town clerk, town of aurora, 100 john west way, box 1000, aurora, Ontario, l4g 6j1, telephone: 905-727-3123 ext. 4771